



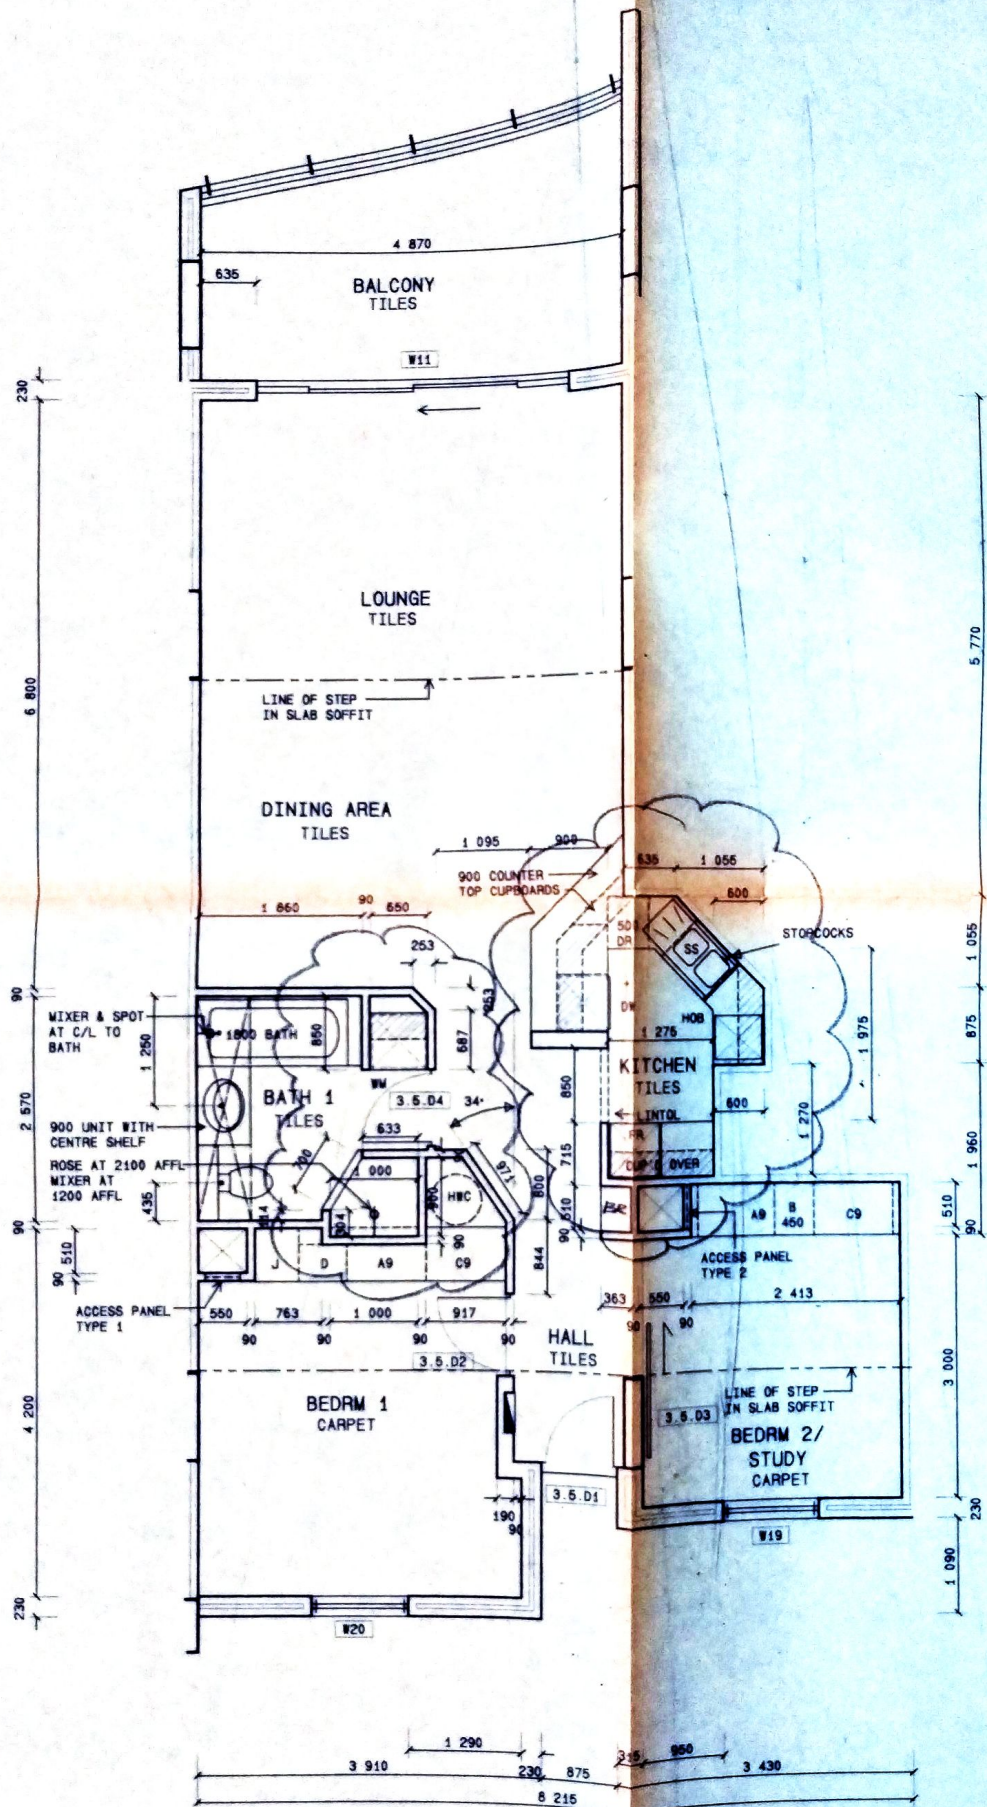

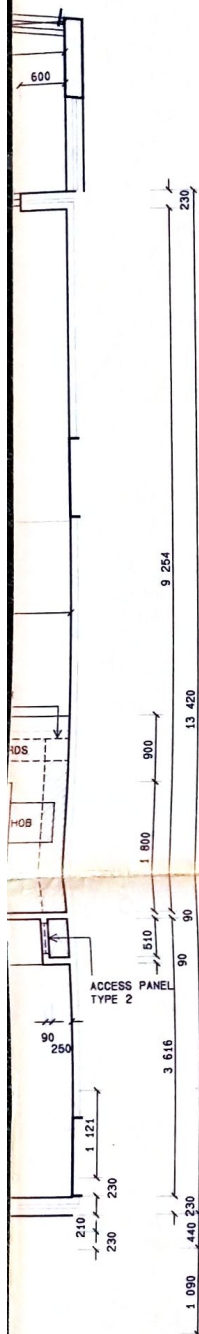

AS BUILT

ISSUE RECORD		DATE		CLIENT		OS		SE		EE		UE		CONTR		CO-ORDINATOR		C. LUFF		COMMAN		CABLE LINE		C. CAMPBELL	
E	95/09/19	MS	UNIT C3 5 - KITCHEN LAYOUT REVISED.																						
D	95/08/04	AH	WINDOW AND DOOR No'S ADDED.																						
C	95/07/05	MS	TYPE NOS. ADDED. - GEN NOTES																						
B	95/04/13	LA	GENERAL UPDATE																						
A	95/02/21	EM	CAD DRAWN																						

Number	Date	Initial	Revision	Details

All dimensions and levels to be checked on site before any work is put in hand.
Copyright reserved

KEY PLAN

The Planning Partnership LANDSCAPE ARCHITECTS	Tel. (021) 48-8365 Fax (021) 45-4136
B H MARAIS & PARTNERS INC. MECHANICAL, ELECTRICAL AND ELECTRONIC ENGINEERS	Tel. (021) 23-8186 Fax (021) 22-1545
Hancock & Paterson Consulting Engineers	Tel. (021) 23-8399 Fax (021) 23-8411
ARUP Consulting Structural Engineers	Tel. (021) 24-8210 Fax (021) 24-8214
SONNEKUS & TOERTEN INC. CONSULTING ENGINEERS	Tel. (021) 23-8260 Fax (021) 24-7677
ADA ARCHITECTURAL DESIGN ASSOCIATES	Tel. (021) 21-4276 Fax (021) 25-1119

	GRANGER BAY MARINA FOR THE GRANGER BAY TRUST
--	--

Title	RESIDENTIAL UNIT TYPES
-------	---------------------------

Drawing	UNIT TYPES - 9 (MOD) - 9&8
---------	-------------------------------

Scale	Date	Drawn
1: 50	95/02/21	eth

CAD	Disk Number	File Name

Project Number	Drawing Number	Revision
ADA/1	R316	E