




REVI	SIONS			
RevID	ChID	Change Name		Date
note				
F	RESF	PONSIBILITY LEV	EL	
	e 1: Ince		No	
		cept Design	No	
		ign Development	No No	
		ocal Authority Approval	No No	
		onstruction & Tender Document	No No	
		tract Admistration	No	
Stag	e 6: As I	Built, Closing	No	
materia	ls. Any d	d dimensions to be checked on site ifferences must be immediately brou- pyright is reserved on all drawings a	ght to the	attention of
CLIE	NT:			


CLIENT:	Mrs C Becker
PROJECT & S	ITE:
STAND NO. ADDRESS: TOWNSHIP: CITY: Mapu STATE/PRO	ESCRIPTION: 57 Mjejane Private Game Reserve to, POSTAL CODE:, /INCE: Mpumalanga South Africa


PROJECT NO.	LAYOUT NO.		REVIS	SION NO.
1939	01.1	1		

CAD TECHN.	APPROVED	INCEPTION DATE:	STATUS
Innocent	Appr by Mar	k 2019	#Project Statu
	111		,,,,,,,,,,,,,,,,,,,,,,,,,,,,,,,,,,,,,,,

Tuesday, November 5, 2019

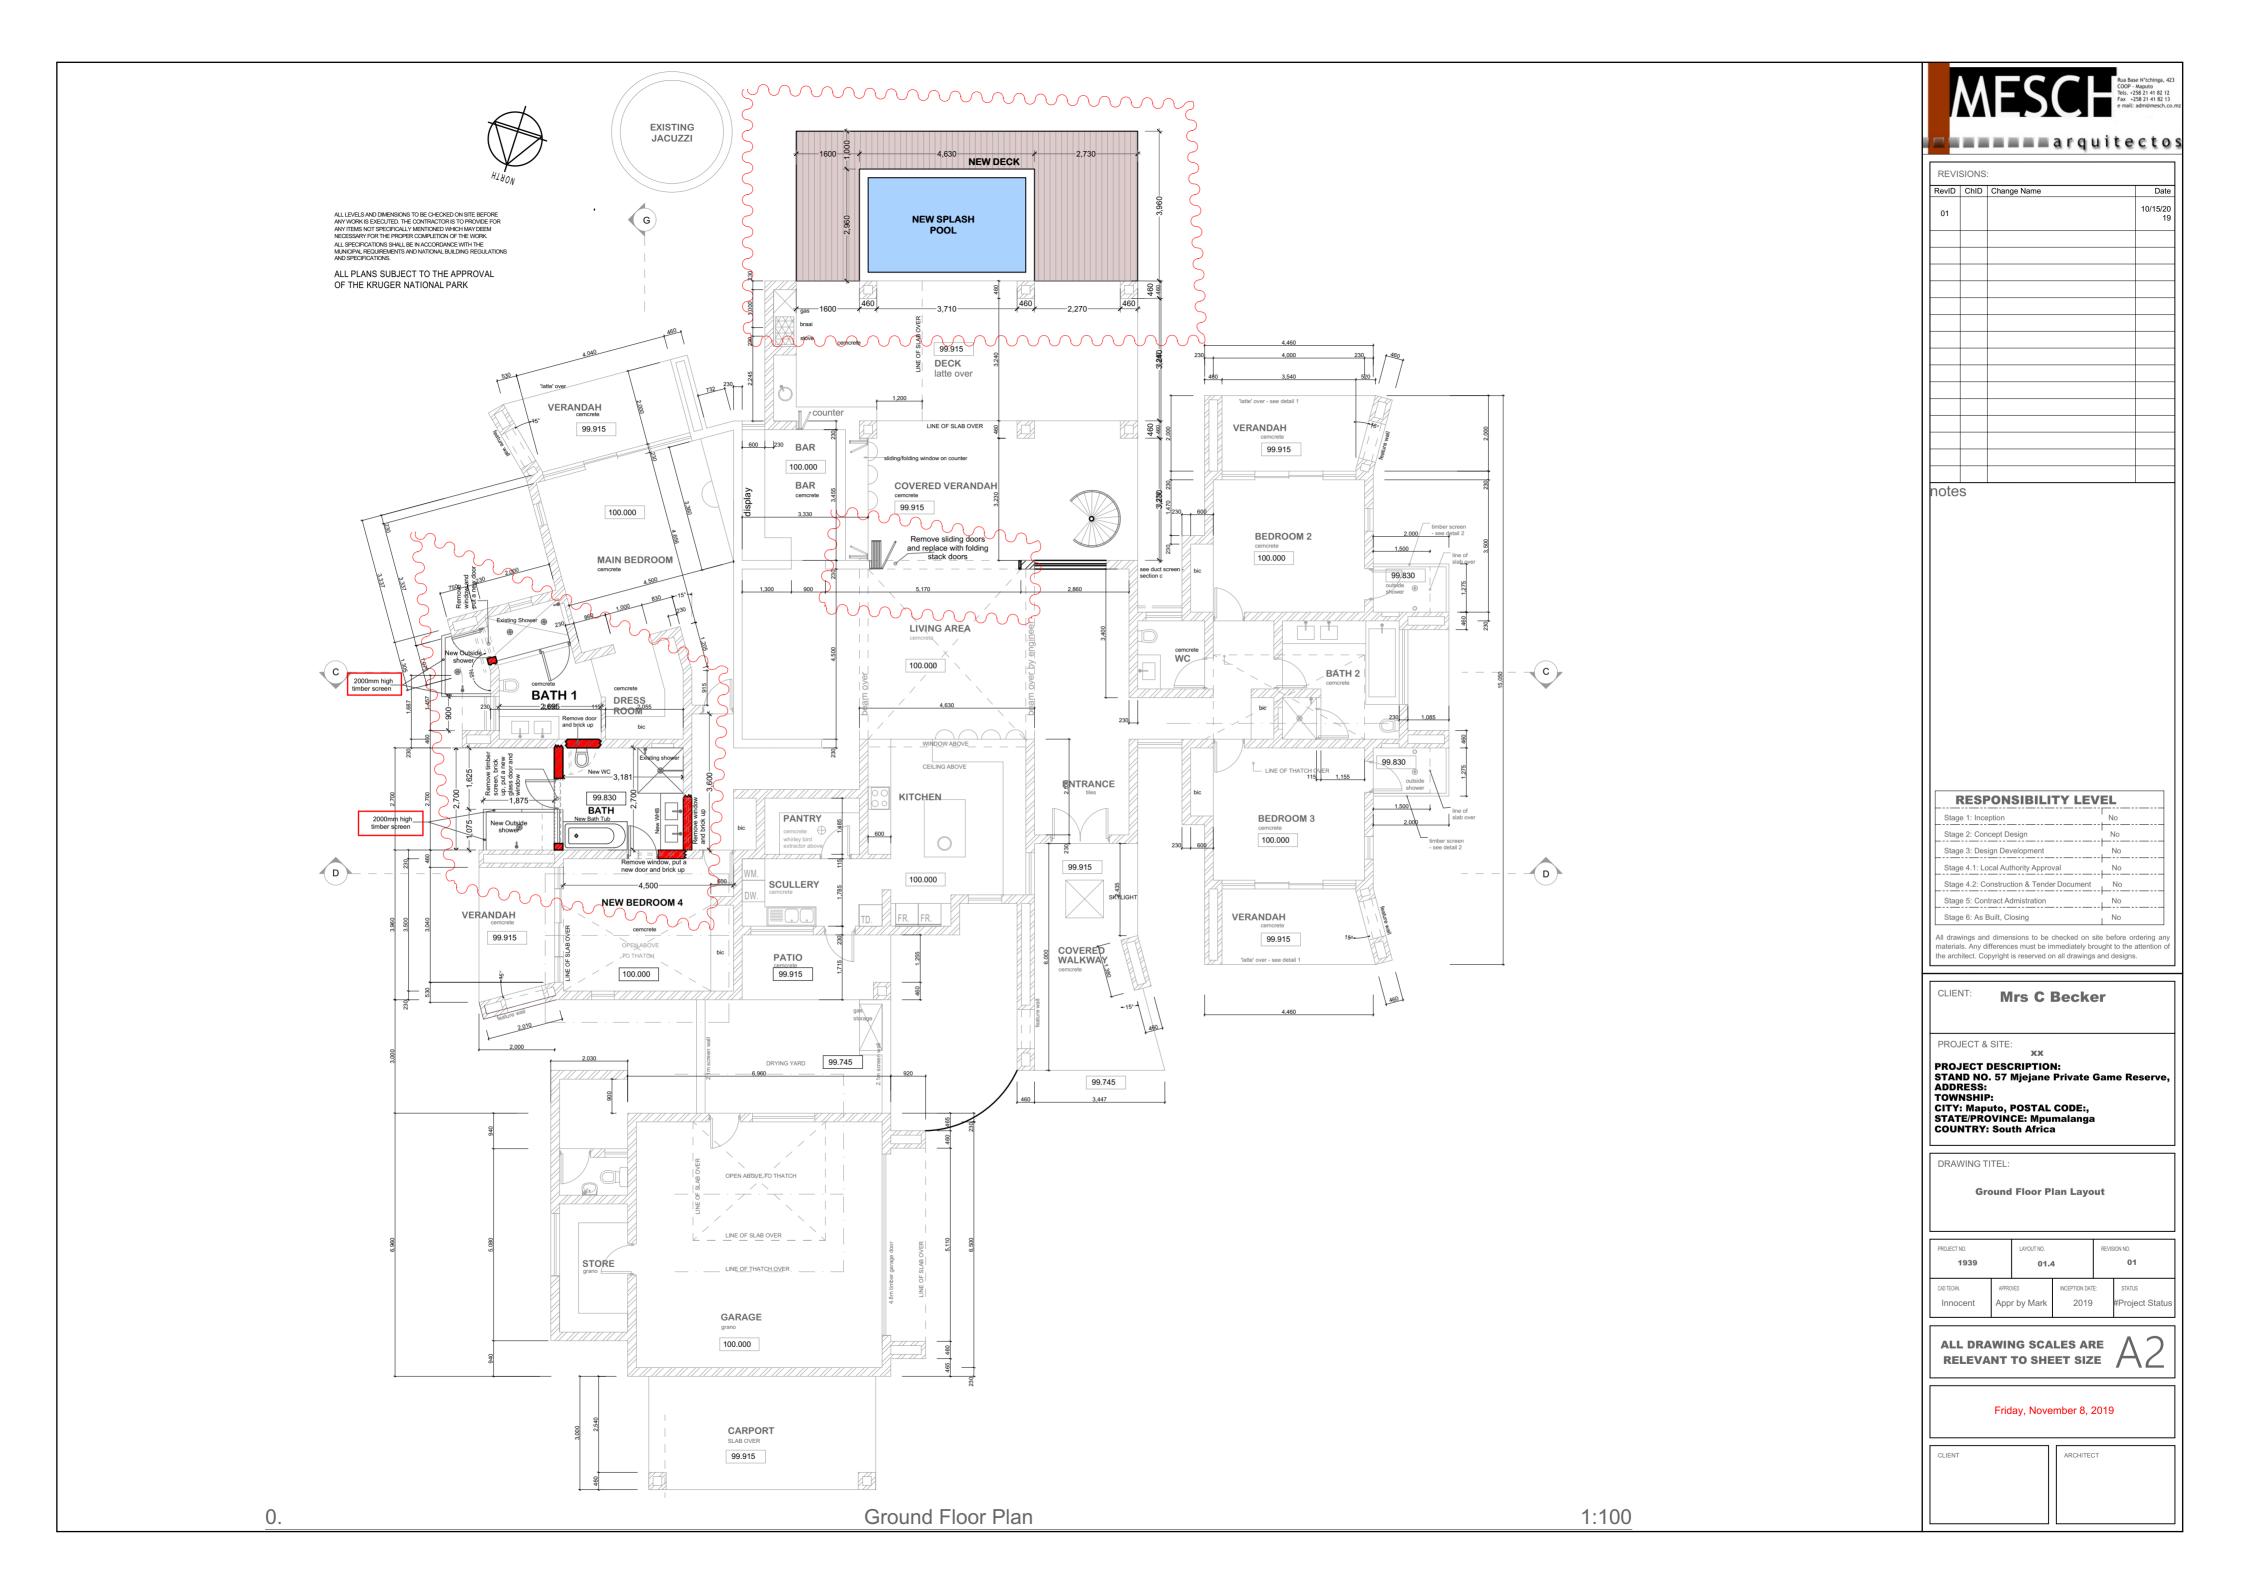

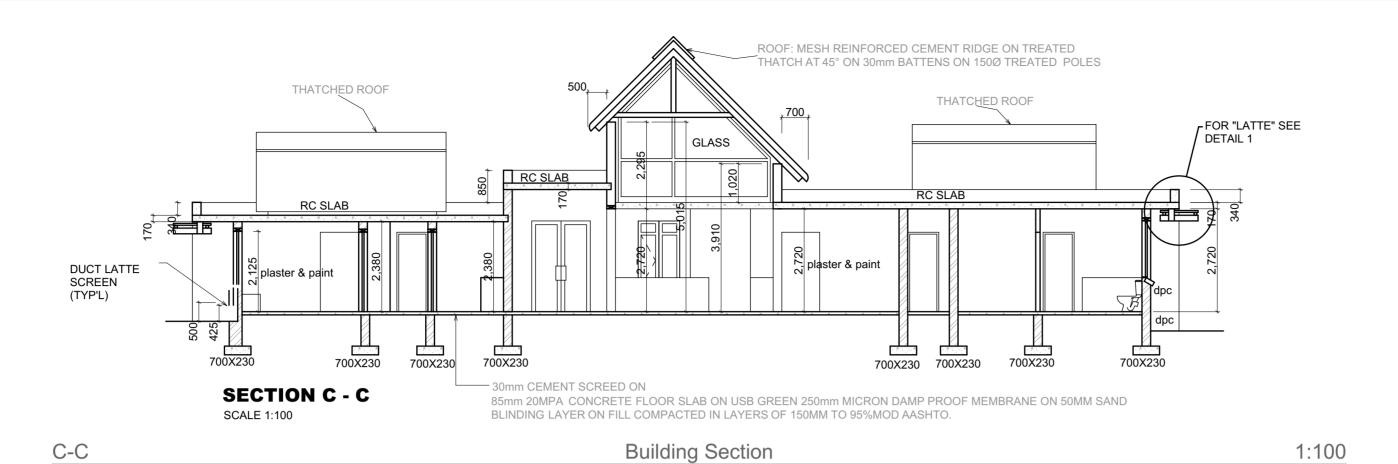

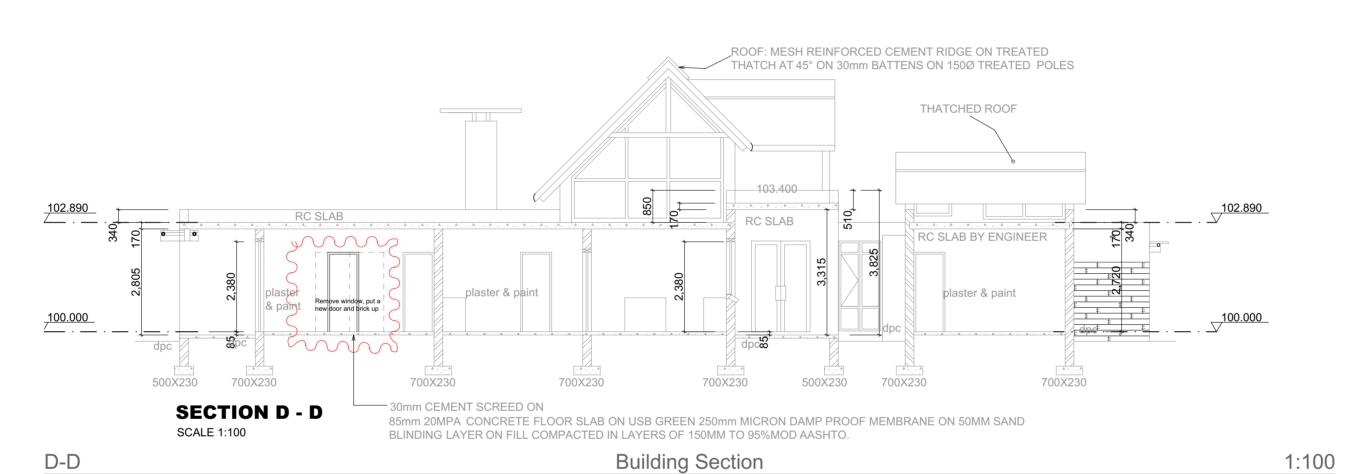

ROOF: MESH REINFORCED CEMENT RIDGE ON TREATED THATCH AT 45° ON 30mm BATTENŞ ON 150Ø TREATED POLES THATCHED ROOF New RC SLAB by engineer 102.890 102.890 RC SLAB RC SLAB 100.000 700X230 700X230 700X230 700X230 700X230 700X230 500X230 700X230 900X230 30mm CEMENT SCREED ON **SECTION G - G** 85mm 20MPA CONCRETE FLOOR SLAB ON USB GREEN 250mm MICRON DAMP PROOF MEMBRANE ON 50MM SAND SCALE 1:100 BLINDING LAYER ON FILL COMPACTED IN LAYERS OF 150MM TO 95%MOD AASHTO.

Rua Base N'tchinga, 423 COOP - Mapputo
Teles - 258 21 41 82 12
Fax - 258 21 41 82 13
e mail: adminmesch.co.mz

RevID	ChID	Change Name	D
ITEVID	OIIID	Change Name	

RESPONSIBILITY LEV	EL
Stage 1: Inception	No
Stage 2: Concept Design	No
Stage 3: Design Development	No
Stage 4.1: Local Authority Approval	No
Stage 4.2: Construction & Tender Document	No
Stage 5: Contract Admistration	No
Stage 6: As Built, Closing	No

	CLIENT:	Mrs	C	Becker
--	---------	-----	---	--------

PROJECT & SITE:

PROJECT DESCRIPTION:
STAND NO. 57 Mjejane Private Game Reserve,
ADDRESS:
TOWNSHIP:
CITY: Maputo, POSTAL CODE:,
STATE/PROVINCE: Mpumalanga
COUNTRY: South Africa

DRAWING TITEL:


**Sections Layout** 


PROJECT NO. <b>1939</b>	LAYOUTN	1.5	REVISION NO.
CAD TECHN.  Innocent	APPROVED Appr by Ma	INCEPTION DAT	

ALL DRAWING SCALES ARE RELEVANT TO SHEET SIZE

Tuesday, November 5, 2019

CLIENT ARCHITECT

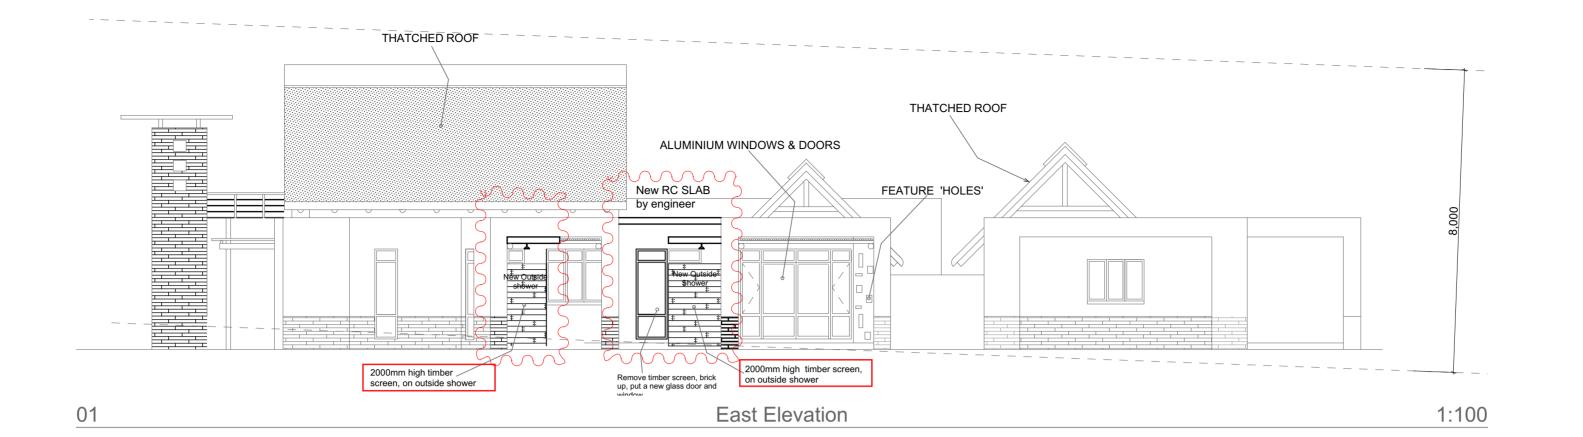

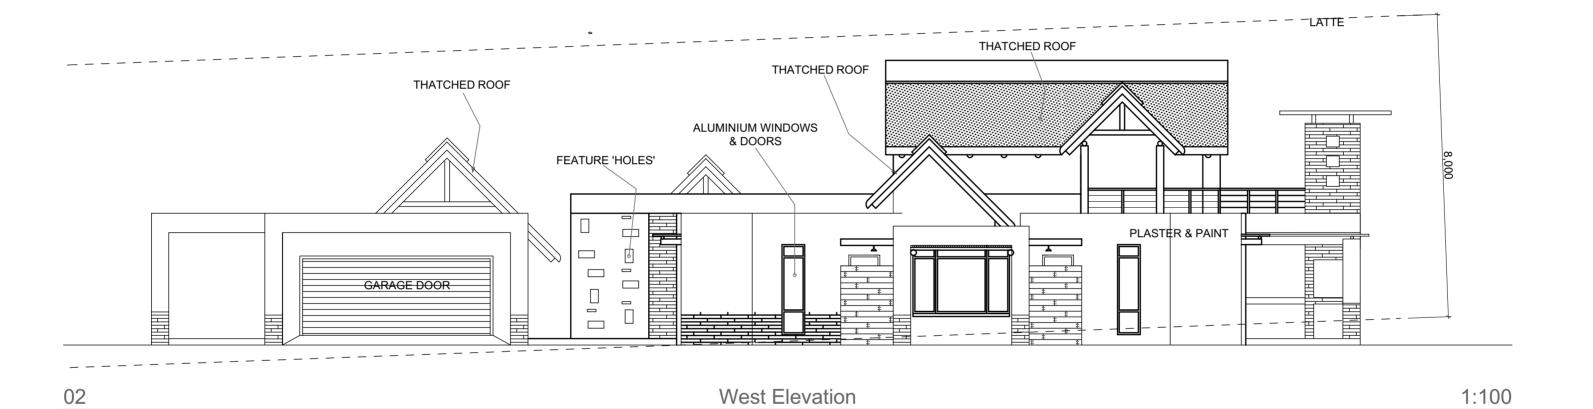



	SIONS		
RevID	ChID	Change Name	Date
ote	S		

Stage 1: Inception	l No
Stage 2: Concept Design	No
Stage 3: Design Development	No
Stage 4.1: Local Authority Approval	No
Stage 4.2: Construction & Tender Document	No
Stage 5: Contract Admistration	No
Stage 6: As Built, Closing	No

materials. Any differences must be immediately brought to the atten the architect. Copyright is reserved on all drawings and designs.

PROJECT & SITE:

XX

PROJECT DESCRIPTION:
STAND NO. 57 Mjejane Private Game Reserve,
ADDRESS:
TOWNSHIP:
CITY: Maputo, POSTAL CODE:,
STATE/PROVINCE: Mpumalanga
COUNTRY: South Africa

 PROJECT NO.
 LAYOUT NO.
 REVISION NO.

 1939
 01.6
 REVISION NO.

 CAD TECHN.
 APPROVED
 INCEPTION DATE:
 STATUS

 Innocent
 Appr by Mark
 2019
 #Project State


**Elevations 1st Layout** 

ALL DRAWING SCALES ARE RELEVANT TO SHEET SIZE


Friday, November 8, 2019

CLIENT

RCHITECT

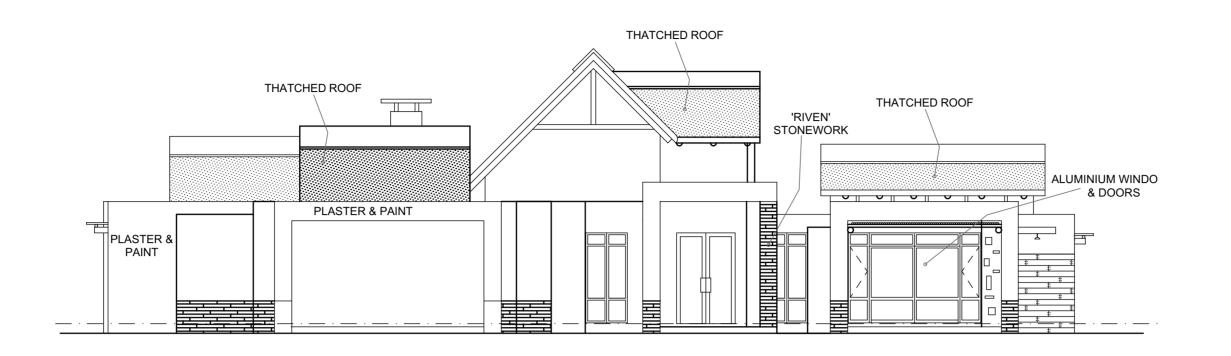

North Elevation 1:100

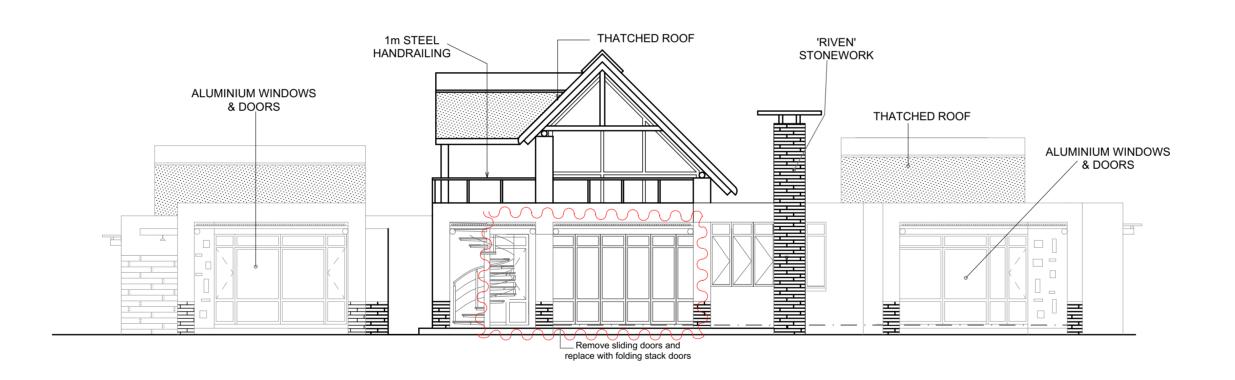

O4 South Elevation 1:100



REVI	SIONS	:	
RevID	ChID	Change Name	D
note	S		

Stage 1: Inception	No
Stage 2: Concept Design	No
Stage 3: Design Development	No
Stage 4.1: Local Authority Approval	No
Stage 4.2: Construction & Tender Document	No
Stage 5: Contract Admistration	No
Stage 6: As Built, Closing	No

All drawings and dimensions to be checked on site before ordering ar materials. Any differences must be immediately brought to the attention the architect. Copyright is reserved on all drawings and designs.

PROJECT & SITE:

XX

PROJECT DESCRIPTION:
STAND NO. 57 Mjejane Private Game Reserve,
ADDRESS:
TOWNSHIP:
CITY: Maputo, POSTAL CODE:,
STATE/PROVINCE: Mpumalanga
COUNTRY: South Africa

PROJECT NO. <b>1939</b>		LAYOUT NO. <b>01.7</b>		REVISION NO.	
CAD TECHN.  Innocent	APPROVED Appr by Mark		INCEPTION DAT		status #Project Status

**Elevations 2nd Layout** 

APPROVED INCEPTION DATE: STATUS
Appr by Mark 2019 #Project Status

ALL DRAWING SCALES ARE RELEVANT TO SHEET SIZE

Tuesday, November 5, 2019

.

RCHITECT



